

South Carolina Department of Health and Environmental Control  
Office of Ocean and Coastal Resource Management  
1362 McMillan Avenue, Suite 400  
Charleston, South Carolina 29405

**December 6, 2013**  
**Permit Amendment Public Notice**  
***Mickey Thompson, OCRM-05-290-M***

The Department has received an application for a permit for the alteration of a critical area. The application was submitted pursuant to the Coastal Zone Management Act (Act 123) of 1977 South Carolina General Assembly. The application in brief, is described as follows:

**LOCATION:** On and adjacent to Marshall Creek at 730 Sonny Boy Lane, Johns Island, Charleston County, South Carolina.  
TMS: 282-00-00-232.

**WORK:** The permittee has requested an after-the-fact amendment to the issued permit. Specifically, the permittee seeks to keep the installed 7' x 15' floating jet dock over the previously permitted single-pile boatlift. The after-the-fact amendment is for modifications to a private, recreational dock.

This public notice is being distributed to all known interested persons and agencies to assist in developing facts on which a decision by the Department can be based. Comments concerning the proposed work must be submitted in writing, setting forth sufficient detail to furnish a clear understanding of the reasons for support or opposition.

Comments regarding this application must be received by the Department on or before **December 16, 2013**. For more information, please contact:  
**Bill Eiser at 843-953-0237 or via email at [eiserwc@dhec.sc.gov](mailto:eiserwc@dhec.sc.gov).**

**NOTE:** Plans depicting the proposed work are available and will be provided upon receipt of a written request or may be viewed on the Department website at **[www.scdhec.gov/environment/ocrm/public\\_notice.htm](http://www.scdhec.gov/environment/ocrm/public_notice.htm)**.

# GRICE SURVEYING, INC.

LAND SURVEYING SERVICES  
410 GENERAL MOULTRIE DRIVE  
BONNEAU, S.C. 29431  
PHONE: (843) 825-3573  
EMAIL: rgrice@gricesurveying.com

GRAPHIC SCALE  
( IN FEET )




SCALE: 1" = 30'

## NOTES:



- 1.) THE BEARINGS SHOWN HEREON ARE MAGNETIC AND AS SUCH ARE SUBJECT TO LOCAL ATTRACTION. AREA CALCULATED BY THE COORDINATE METHOD.
- 2.) THIS PROPERTY IS LOCATED IN A SPECIAL FLOOD HAZARD AREA, ZONE AE-11, AS PER SCALING FROM FEMA FIRM 45019C0489J DATED 11/17/04. (COMMUNITY #455413). CONSULT WITH LOCAL BUILDING OFFICIALS FOR ANY CHANGES TO FIRM OR SPECIAL RESTRICTIONS BEFORE ANY CONSTRUCTION.
- 3.) THIS PLAT REPRESENTS A SURVEY BASED ON THE REFERENCES LISTED HEREON AND FOUND MONUMENTATION AND IS NOT THE RESULT OF A TITLE SEARCH.
- 4.) THERE HAS BEEN NO ENVIRONMENTAL OR UTILITY INVESTIGATIONS, SURFACE OR SUBSURFACE, DONE FOR THIS SURVEY. SOME IMPROVEMENTS TO SITE NOT SHOWN HEREON.

## REFERENCES:

- 1.) PLAT BY COASTAL SCIENCE & ENGINEERING  
DATED JULY 29, 1990  
PB CD, PG 5  
CHARLESTON COUNTY RMC

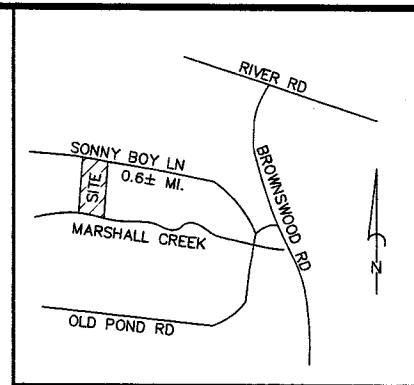

LOCATION MAP N.T.S.

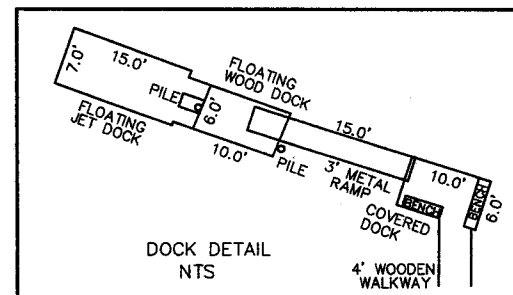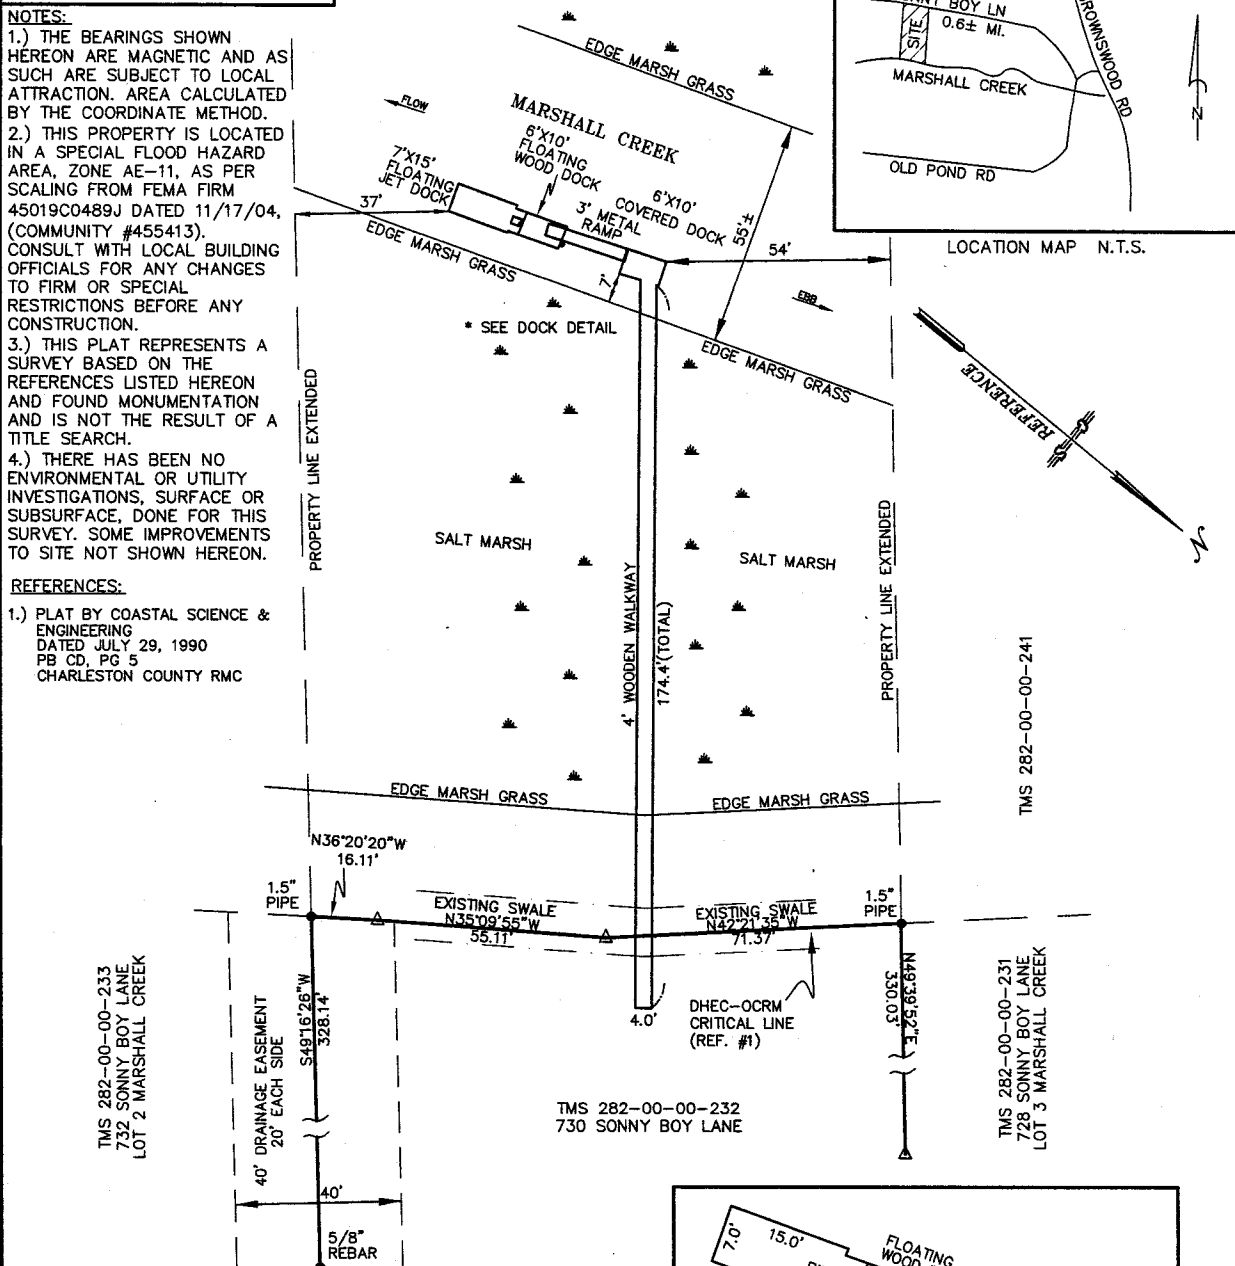

DOCK DETAIL  
NTS

AMENDMENT REQUEST FOR ASBUILT  
OCR M PERMIT 05-290M  
EXISTING DOCK  
730 SONNY BOY LANE  
TMS 282-00-00-232  
LOCATED ON JOHNS ISLAND  
CHARLESTON COUNTY, SC

OWNED BY:  
LARRY MITCHELL THOMPSON & LINDA ELAINE THOMPSON

DATE: NOVEMBER 9, 2013

SCALE: 1" = 30'

JOB #13-0054



I, Randolph J. Grice, a Registered Land Surveyor of the State of South Carolina, do hereby state that to the best of my knowledge, information, and belief, the DOCK ASBUILT plat shown hereon was made in accordance with the requirements of the South Carolina Minimum Standards Manual, per Article 4 Regulation 420-F; that the sole purpose of this DOCK ASBUILT plat is for governmental agency review and approval processes and it is not to be used to transfer title to property; that the information shown hereon is based on actual field measurements which meets or exceeds the requirements for a Class A survey as specified therein.

*[Signature]* 11-12-13  
Randolph J. Grice, PLS S.C. Registration Number 14183

Reduced - NTS

ATF  
amendment  
OCR M-05-290-M